

SHERIDAN COUNTY, WYOMING PERMIT TO CONSTRUCT

New Renewal Modified

Applicant: FALLIS JOHN
(Last) (First) (Middle)

Mailing Address: 38620 COUNTY ROAD 29 Box 50
(Street or P.O. Box)
WYARNO WY 82845
BOULDER CO 80302
(City) (State) (Zip)

Site Address: 536 ULM ROAD
(Road or Street)
SHERIDAN WY 82801
(City) (State) (Zip)

This permit hereby authorizes the Applicant to construct, install or modify a small waste water facility located in the _____ Subdivision, Block _____, Lot _____, (Legal Description) _____ NW ¼: Section 13 _____, T 55 N, R 82 W; in the County of Sheridan in the State of Wyoming. This permit shall be effective for a period of one (1) year from the date of issuance.

Authorized by:


County Engineers Office
County Inspector


1-2-97

Date of Issuance

5-14-97

As Built Drawing
John Fallis
536 Ulm Road

⊙ well

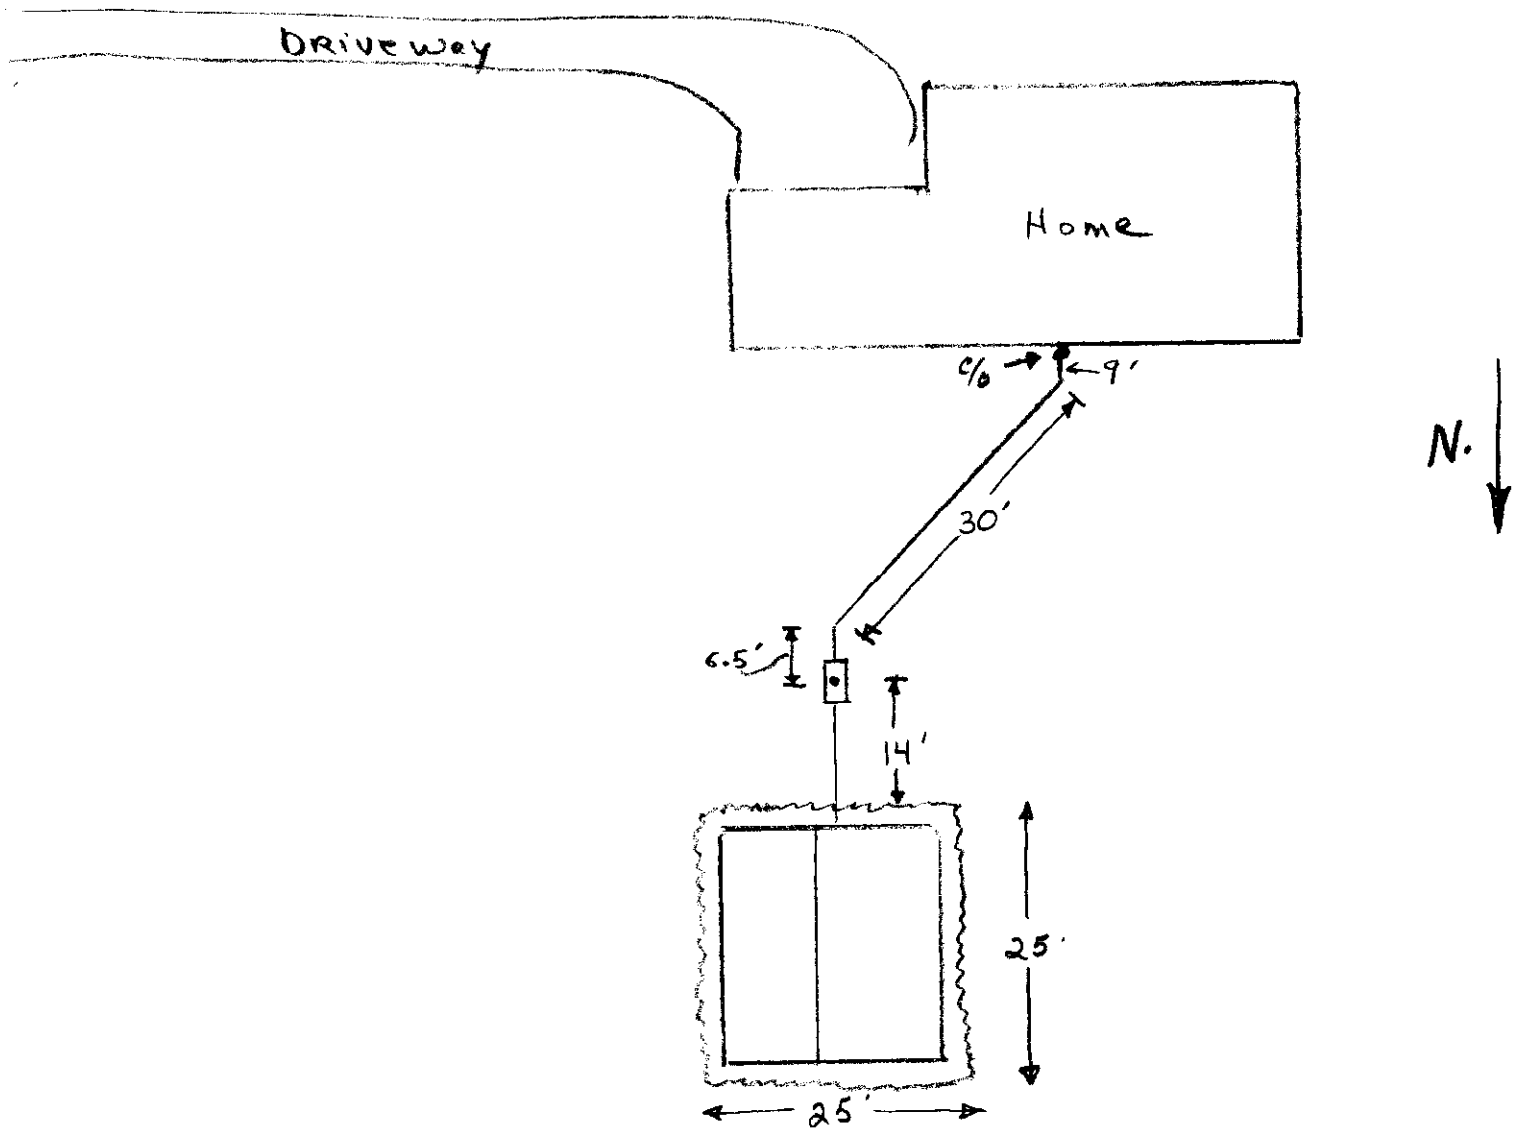

Paid 12-30-96

SMALL WASTEWATER FACILITY PERMIT

SHERIDAN COUNTY, WYOMING

Fee \$50.00

NEW X OR REPLACEMENT _____ SYSTEM

SITE ADDRESS: 536 ULM RD WYARNO, WY. 82845
Subdivision: _____ Bk _____ Lot NW 1/4; Sec. 13; T 55 N; R 82 W
Owner/Sponsor: JOHN FALLIS Installer: EVANS EXC
Mail Address: 38620, Co. Rd 29 Mail Address: 625 S. MAIN, SHERIDAN
Telephone: (303) 646-4125 Telephone: 672-8401

GENERAL INFORMATION

- No. of Living Units: SINGLE
- No. of Bedrooms: 3
- Soil type: 24" Topsoil Sandy loam
- Average of percolation test: _____ min / inch
- Ground slope: 2' feet/100 ft.
- Water supply: Community well
Municipal: _____ Private: X
- Size of Lot: _____ Acres: 1.91
- Depth to Ground Water if Less Than 7 feet?
more than 7 feet
- Remarks: _____


SEPTIC TANK

- Liquid Capacity: 1,000 gallons
- Material: Concrete
- Length: 8 Width: 4 Depth: 6
- Outlet Depth (from ground level): 2' ft.
- Distance from: Well: 120' Waterlines: _____

SECONDARY TREATMENT

- Field: _____ Bed: X Other: _____
- Total Sq. Ft. Required: _____
- No. of Lines: _____ Ends Connected: _____
- Trench/Bed: (width) _____ (length) _____
- Depth of gravel: (below pipe) _____ Above: _____
- Washed gravel: _____ Size: _____
- Depth of cover over pipe: _____
- Distance from: Well: 150' Waterlines: _____

PLOT PLAN (show lot lines, well, house, direction or slope, water lines, sewer lines, septic tank with dimensions; Indicate North.)

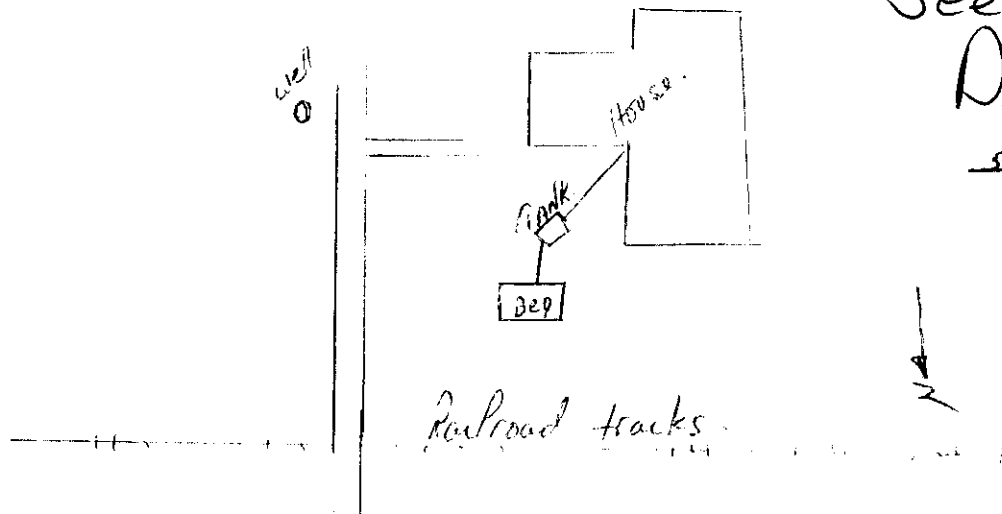

See As Built
Drawing!
5-14-97 SRB

This system will be constructed in accordance with above specifications, design standards and regulations governing sewage systems in the State of Wyoming and Sheridan County.

The plans and specifications as shown are approved.

SR Bond 1-2-97
COUNTY INSPECTOR Date

K. Evans
APPLICANT

The above system has been inspected and found to comply with the plans and specifications, but this permit in no way guarantees the continued performance of the system. System shall not be covered until inspected. Request in advance

Installed by: Buckley Const.
Approved: SR Bond 5-15-97
County Inspector Date

Inspected by: SR Bond 5-14-97
Date