

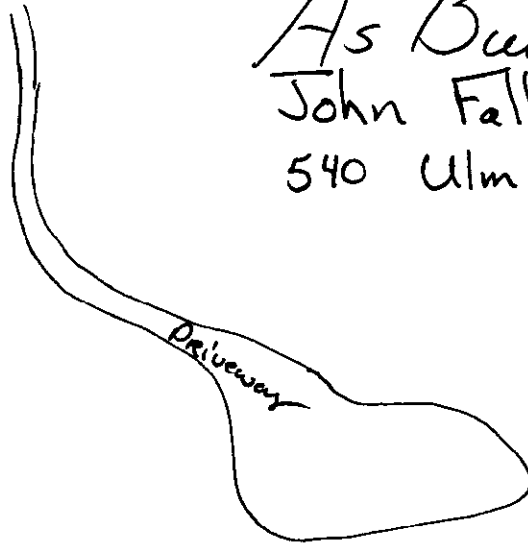
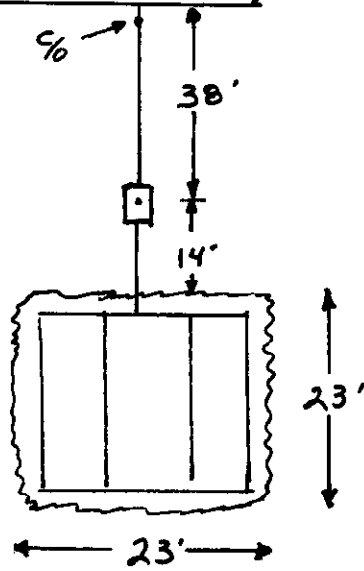


As Built Drawing
John Fallis
540 Elm Road

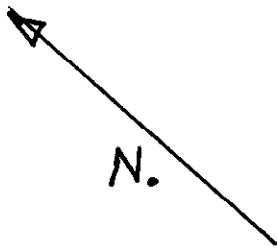

Well

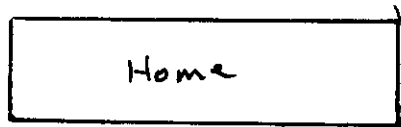

Pd 12-30-96

SMALL WASTEWATER FACILITY PERMIT

SHERIDAN COUNTY, WYOMING

Fee \$50.00

NEW OR REPLACEMENT _____ SYSTEM

SITE ADDRESS: 540 ULM RD, WYARNO, WY. 82845.

Subdivision: _____ Bk _____ Lot NW 1/4; Sec. 13; T 55 N; R 82 W

Owner/Sponsor: John FALLIS.

Installer: EVANS Exc

Mail Address: Box 50
53620 Co Rd 19 Co.

Mail Address: 625 S Main St. Sheridan.

Telephone: (303) 646-4125
WYARNO WY 82845

Telephone: 672-8401

GENERAL INFORMATION

1. No. of Living Units: Single.

2. No. of Bedrooms: 2

3. Soil type: 24" topsoil Sandy hard pan

4. Average of percolation test: 7 min / inch

5. Ground slope: flat. feet/100 ft.

6. Water supply: Community _____

Municipal: _____ Private:

7. Size of Lot: 4 Acres: 40

8. Depth to Ground Water if Less Than 7 feet?
more than 7 feet.

9. Remarks: _____

SEPTIC TANK

1. Liquid Capacity: 1000 gallons

2. Material: Concrete.

3. Length: 8 Width: 4 Depth: 6

4. Outlet Depth (from ground level): 2' ft.

5. Distance from: Well: 100' Waterlines: _____

SECONDARY TREATMENT

1. Field: _____ Bed: Other: _____

2. Total Sq. Ft. Required: 417

3. No. of Lines: 3 Ends Connected: Yes

4. Trench (Bed) (width) 20' (length) 21'

5. Depth of gravel: (below pipe) 6" Above: 2"


6. Washed gravel: — Size: 1/2" to 2 1/2"

7. Depth of cover over pipe: 12" +

8. Distance from: Well: 100' Waterlines: _____

PLOT PLAN (show lot lines, well, house, direction or slope, water lines, sewer lines, septic tank with dimensions; Indicate North.)

See As Built
Drawing!
5-19-97
SRB

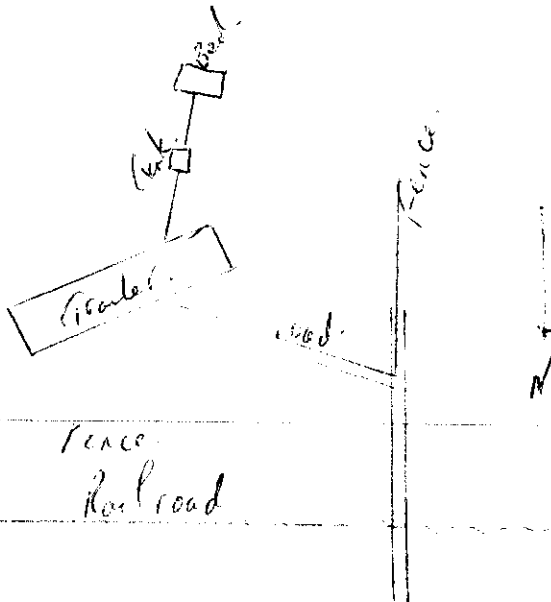

This system will be constructed in accordance with above specifications, design standards and regulations governing sewage systems in the State of Wyoming and Sheridan County.

The plans and specifications as shown are approved.

SR Bond
COUNTY INSPECTOR 1-2-97
Date

K. Leland
APPLICANT

The above system has been inspected and found to comply with the plans and specifications, but this permit in no way guarantees the continued performance of the system. System shall not be covered until inspected. Request in advance.

Installed by: Buckley Const.
Approved: SR Bond 5-27-97
County Inspector Date

Inspected by: SR Bond 5-19-97
Date